



TOOMBS COUNTY BOARD OF
COMMISSIONERS
100 Courthouse Square
PO Box 112
Lyons, Georgia 30436
912-526-3311



**REQUEST FOR PROPOSAL
PROJECT 2021-EMSEMA-BLDG-001**

The Toombs County Board of Commissioners (Owner) are requesting proposals for the telephones & telephone systems, internet and TV services at the current under construction site located at 509-B Maple Drive, Vidalia, Georgia for the new Toombs-Montgomery Emergency Medical Services (EMS) and the Toombs County Emergency Management Agency (EMA) Building. These are two separate agencies that will share a receptionist position.

Phones – This includes equipment & accessories and associated phone system/software for ten (10) telephone drops. See Attachment A

One (1) Telephone for shared receptionist.

EMS – Six (6) phones and one (1) fax Line with five (5) Separate lines; 912-537-5823 (Main Line), 912-535-0522 (Roll Over), 912-535-0520 Director, 912-535-0521 Supervisor; fax line 912-538-5362. See Attachment A

EMA – Three (3) phones and one (1) fax line with three (3) separate lines: 912-526-6021 (Main Line), 912-526-6424 (Rollover line); fax line 912-526-9651. See Attachment A

Emergency Operations Control Room – This EMA room will contain eight (8) Data Outlets and eight (8) Quad Outlets – See Attachment A

Internet Access must have a minimum of 100M/100M Symmetrical Bandwidth

TV – There will be fourteen (14) TV locations – See Attachment B

Provider of services is responsible for bringing their lines to the box located on the SW corner of the building to access one of 4 each 2 inch conduits to access the IT Room.

If contract is required, please provide the terms of the contract.

Any questions or clarifications should be sent via email to jjones.toombsco@bellsouth.net. All questions are due by 5:00 PM on May 6, 2021. An email response will be provided to all who have received this Request for Proposals no later than 5:00 PM May 10, 2021.

Proposals are due by 12:00 Noon on May 12, 2021. Proposals can be submitted by mail to Toombs County Board of Commissioners at PO Box 112, Lyons, GA. 30436, or delivered to 100 Courthouse

Square, Suite 24, Lyons, GA. 30436 or by email by emailing jjones.toombsco@bellsouth.net.
Proposals do not have to be sealed.

Proposals will be evaluated by the owner and General Contractor, Harry Moses Construction.
Proposals will be evaluated based a combination of cost, experience, reputation, contract terms,
quality of equipment & accessories and warranties.

ATTACHMENT A



TOOMBS COUNTY
EMS BUILDING


TOOMBS COUNTY
EMA BUILDING

12/11/20

EMA Furniture Plan
Revised 12.17.20

FP1.1

Revised 4.29.21

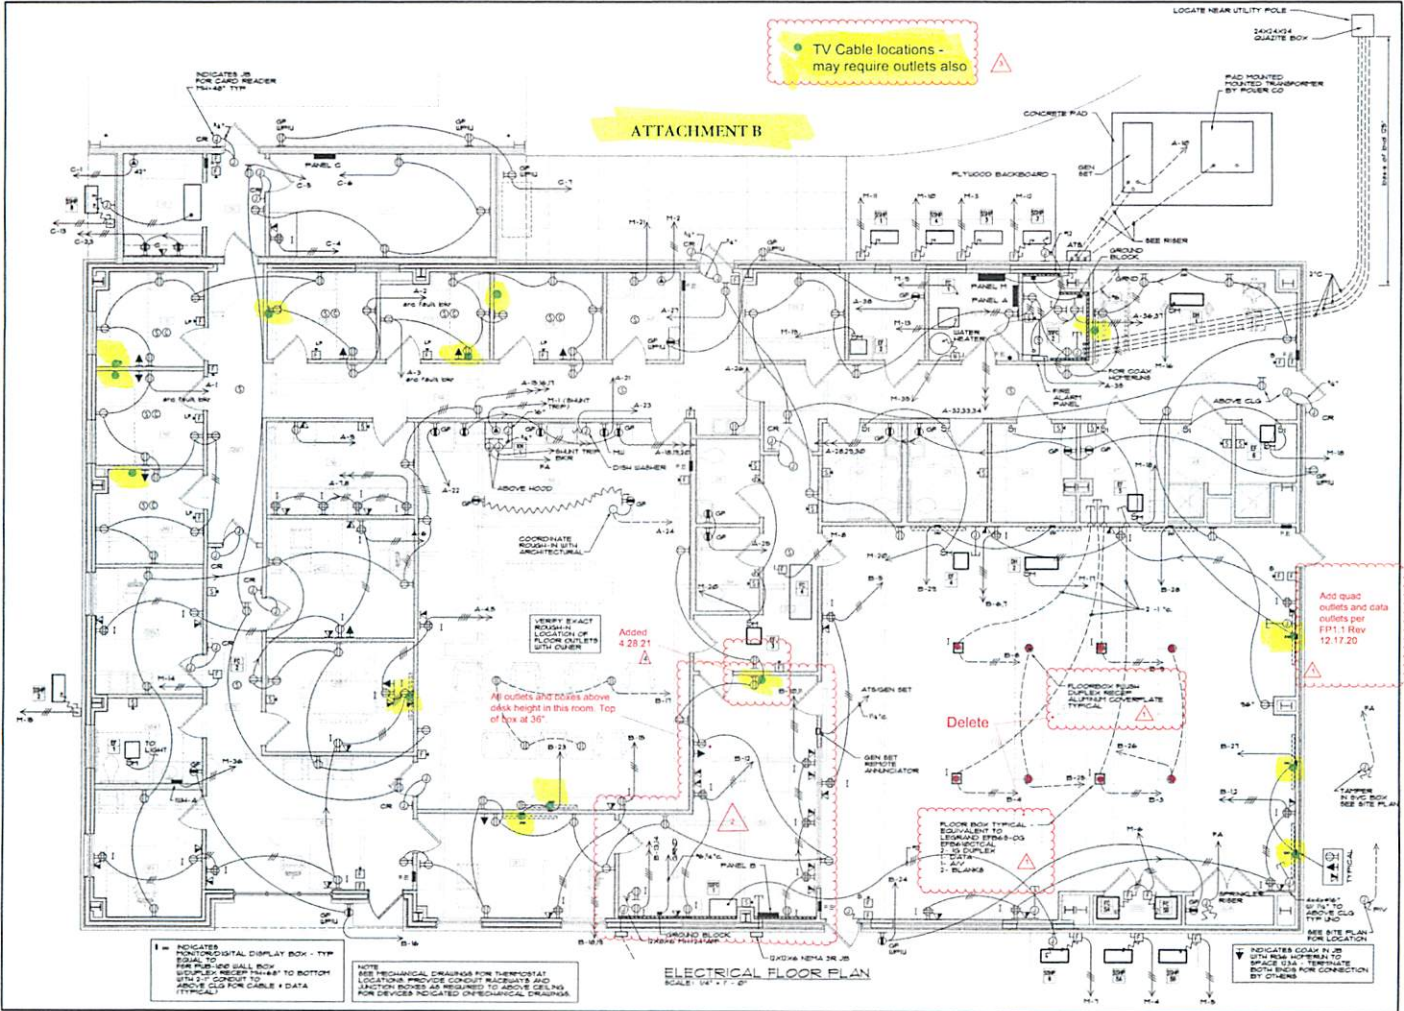

INDICATES MONITORIAL DISPLAY BOX - TYP EQUAL TO PER REVERSE SIDE OF SHEET. RECEPT TRAYS TO BOTTOM AREA. CLG FOR CABLE & DATA (TYPICAL)

NOTE: SEE MECHANICAL DRAWINGS FOR THERMOSTAT LOCATIONS. PROVIDE CONDUIT RACKS AND ANCHOR BOWS AS REQUIRED TO ABOVE CEILING FOR DEVICES INDICATED ON MECHANICAL DRAWINGS.

ELECTRICAL FLOOR PLAN
SCALE: 1/4" = 1'-0"




PROPOSED EMA-EMS BUILDING FOR TOOMBS COUNTY

PROJECT NO: 20-010
SHEET TITLE: Rev 1 - 12.01.20
Rev 2 - 3.30.21
Rev 3 - 3.30.21
Rev 4 - 4.29.21

DATE: 2/NOV/2020
DRAWN BY: DMM
CHECKED BY: BMM

SHEET NUMBER: **E2.1**